


FOR REFERENCE ONLY
This drawing is representative of the documentation requirements of Schedule 3. The content should not be relied upon as accurate for another building project.

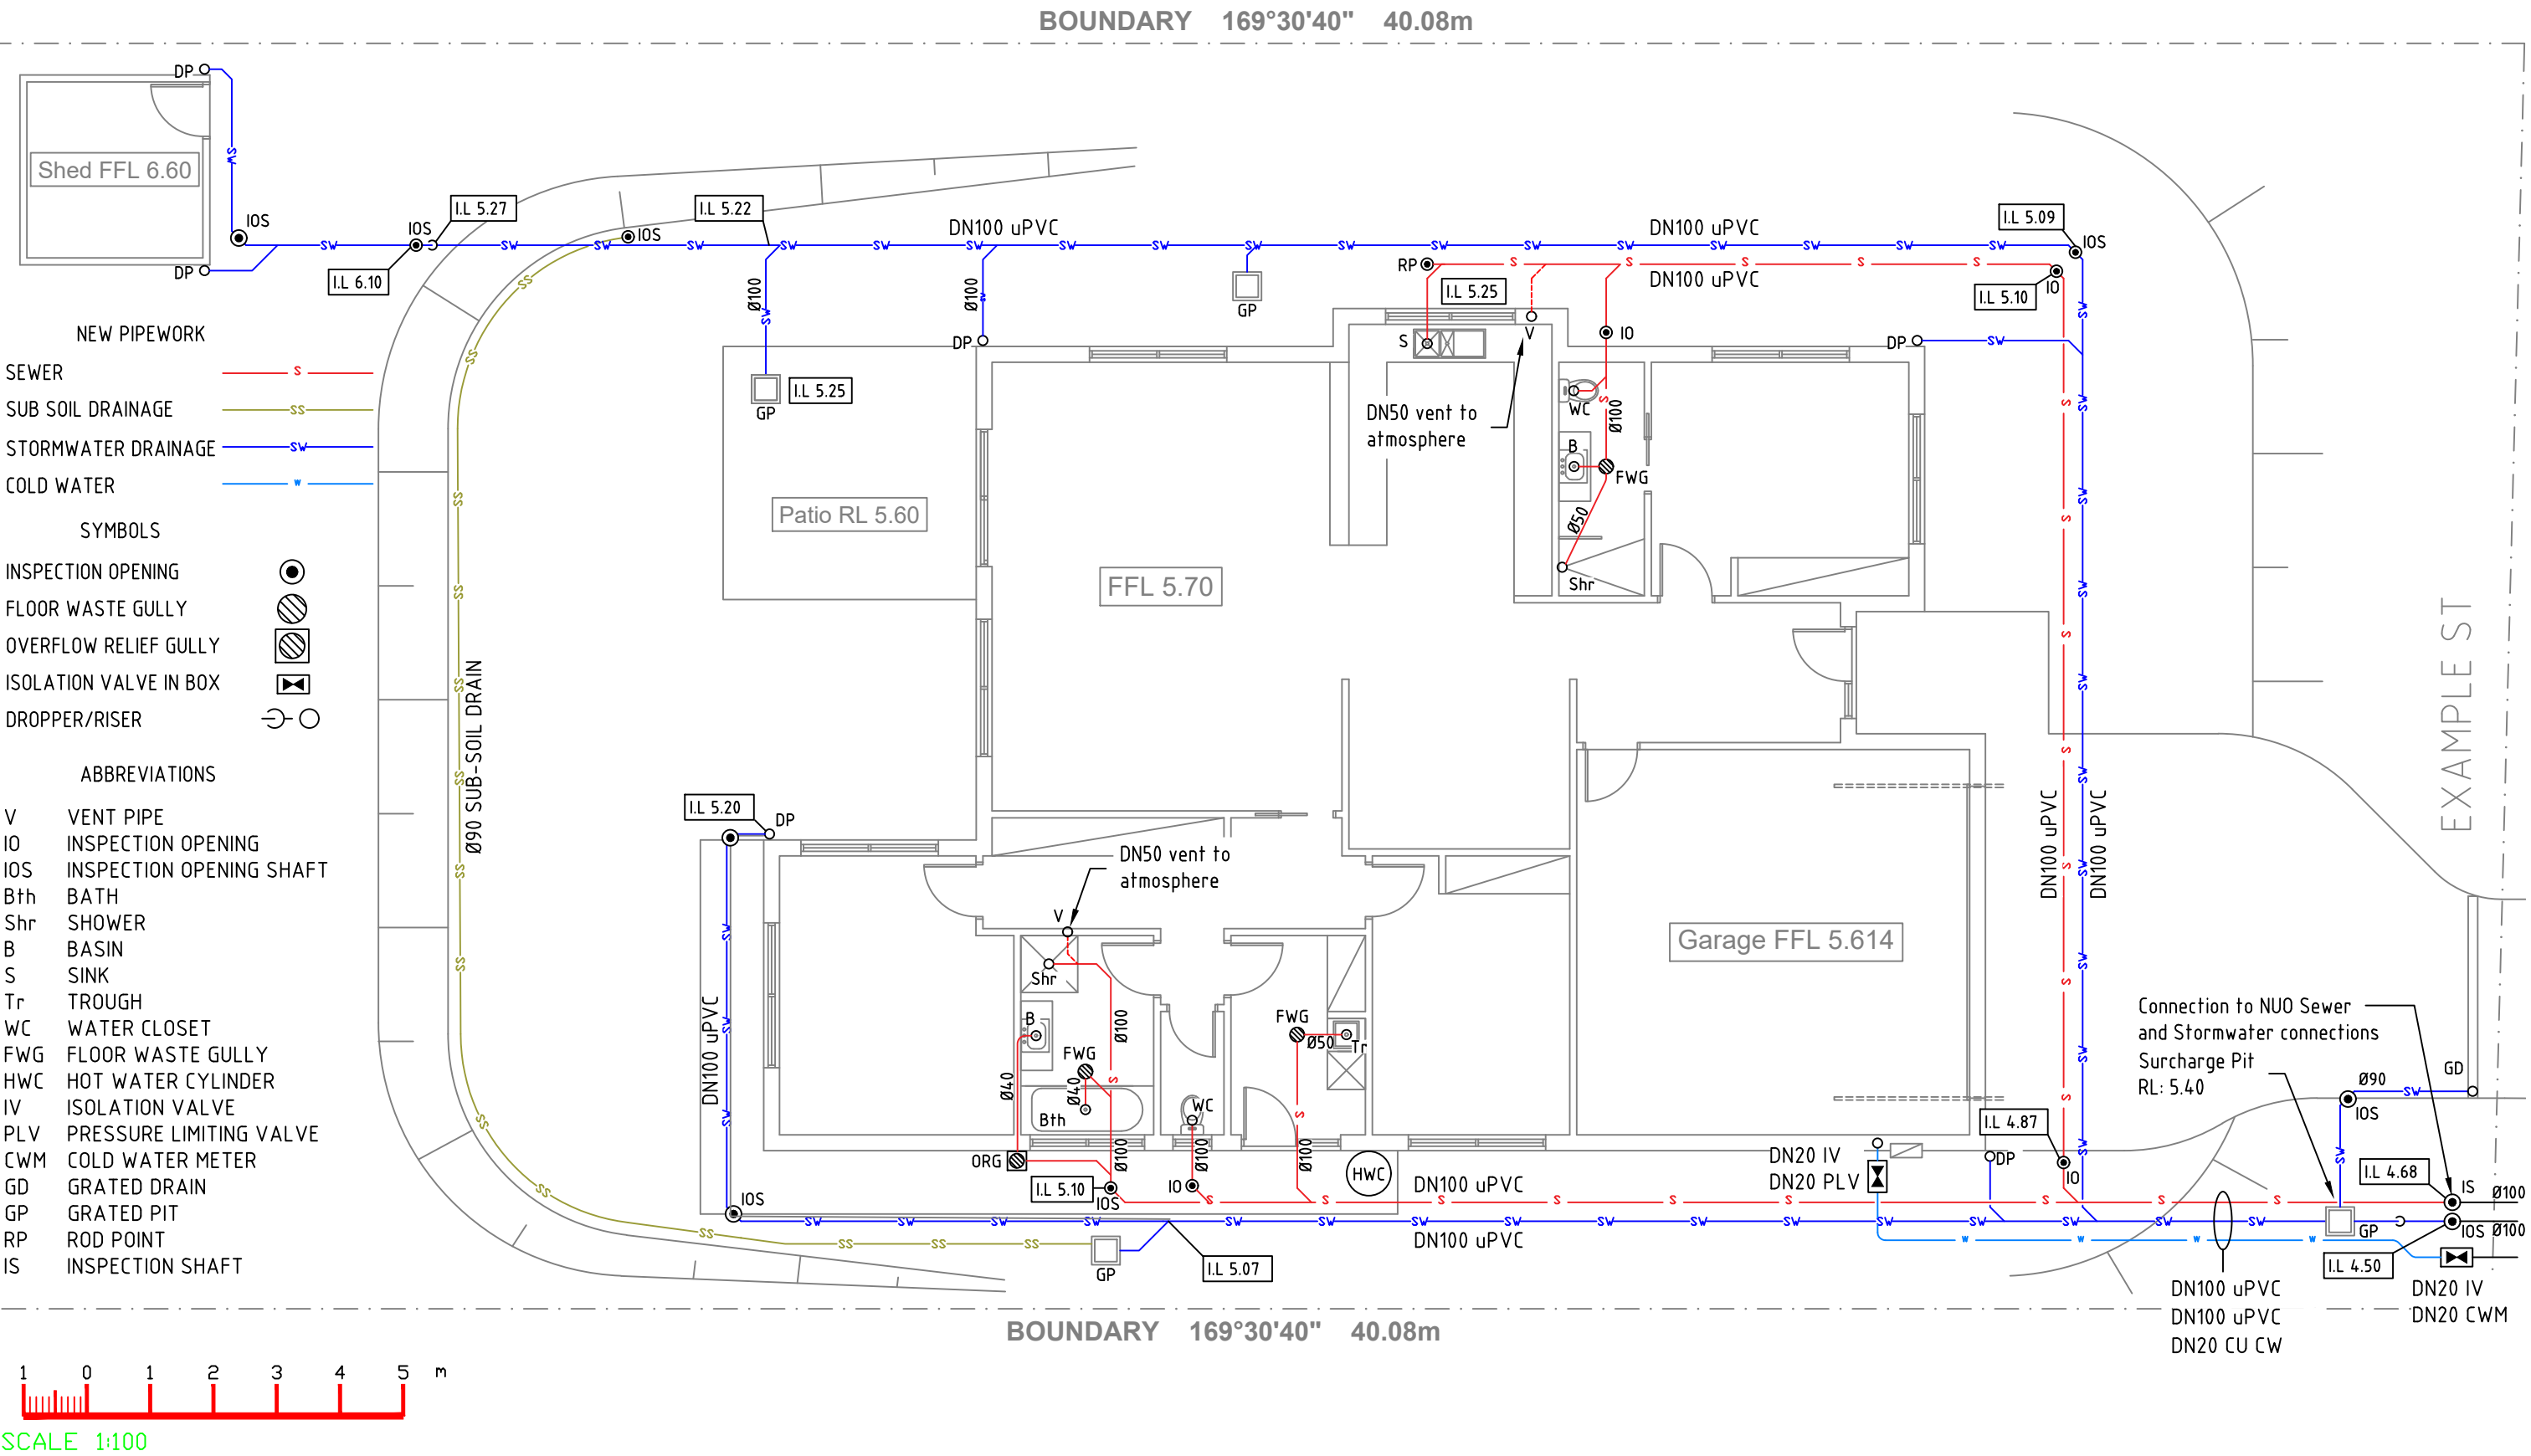

		<div>Plumber Certifier</div> <div>Name</div> <div>Address</div> <div>Phone number</div> <div>License No.</div>	<div>Permit Number</div> <div>Owner / Client:</div> <div>Building and Plumbing Standards & Regulation</div> <div>Project:</div> <div>New Dwelling</div> <div>I Example Street, TASMANIA</div>	<div>Drawing Title:</div> <div>Director's Specified List</div> <div>Schedule 3: Class 1a</div> <div>As-Constructed Drawing</div>	<div>Date:</div> <div>01/07/2023</div> <div>Scale:</div> <div>1:100 @ A3</div>	<div>Status:</div> <div>INFORMATION</div> <div>Drawing No.:</div> <div>A01</div> <div>Rev</div> <div>-</div>
Rev.	Amendment					